

DoubleTree by Hilton Hotel

2050 Gateway Pl, San Jose, CA 95110

WEST 2022 LAYOUTS

(DRAFT - NOT FINAL)


last updated 7/5/22

Qs? chairs@magwest.org or

#west-layouts, @westchairs in Slack


SECOND FLOOR

We get these this year!

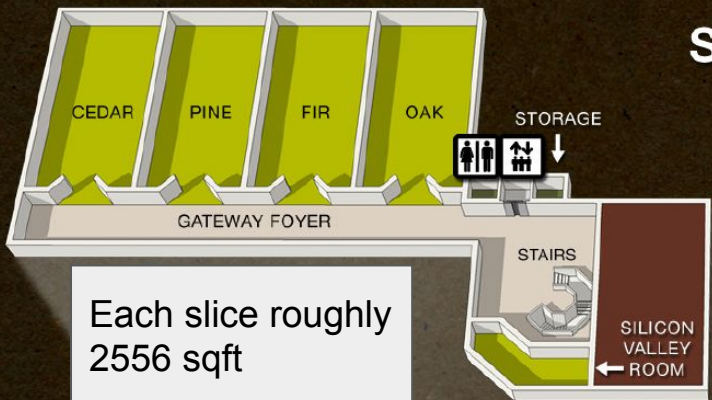

Each room roughly 1000sqft

Each slice roughly 2556 sqft

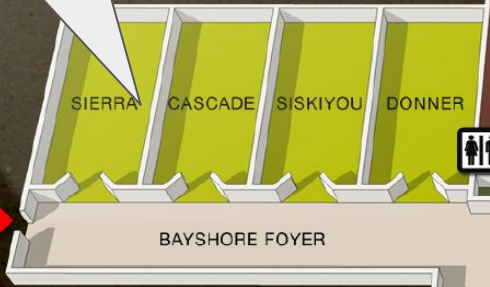

LOBBY LEVEL

**DoubleTree by Hilton
(Full Layout)**




White lines = airwall option

Red lines = possible airwall placement

Black lines = possible pipe & drape placement

Airwall placement, entrances/exits, and exact internal layouts TBD with Chito & DHs

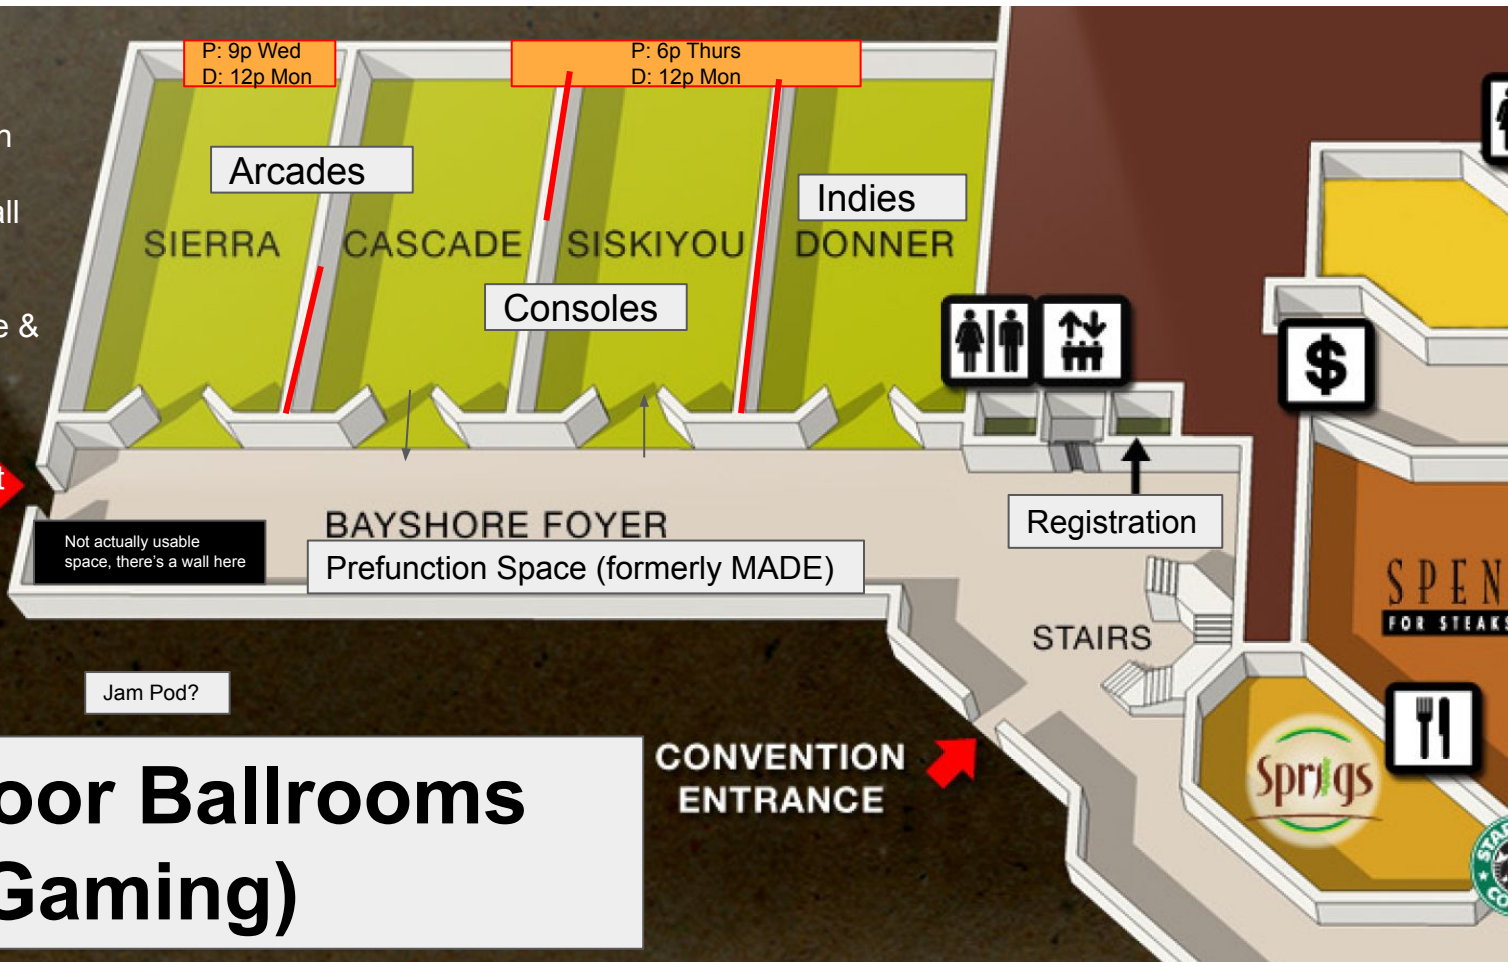

P: 9p Wed
D: 12p Mon

P: 6p Thurs
D: 12p Mon

Arcades

Indies

SIERRA

CASCADE

SISKIYOU

DONNER

Consoles

BAYSHORE FOYER

Prefunction Space (formerly MADE)

Registration

STAIRS

Not actually usable space, there's a wall here

Jam Pod?

\$

SPEN FOR STEAKS

Sprigs

Fork and knife icon

CONVENTION ENTRANCE


First Floor Ballrooms (Gaming)

White lines = airwall option

Red lines = possible airwall placement

Black lines = possible pipe & drape placement

Airwall placement, entrances/exits, and exact internal layouts TBD with Chito & DHs

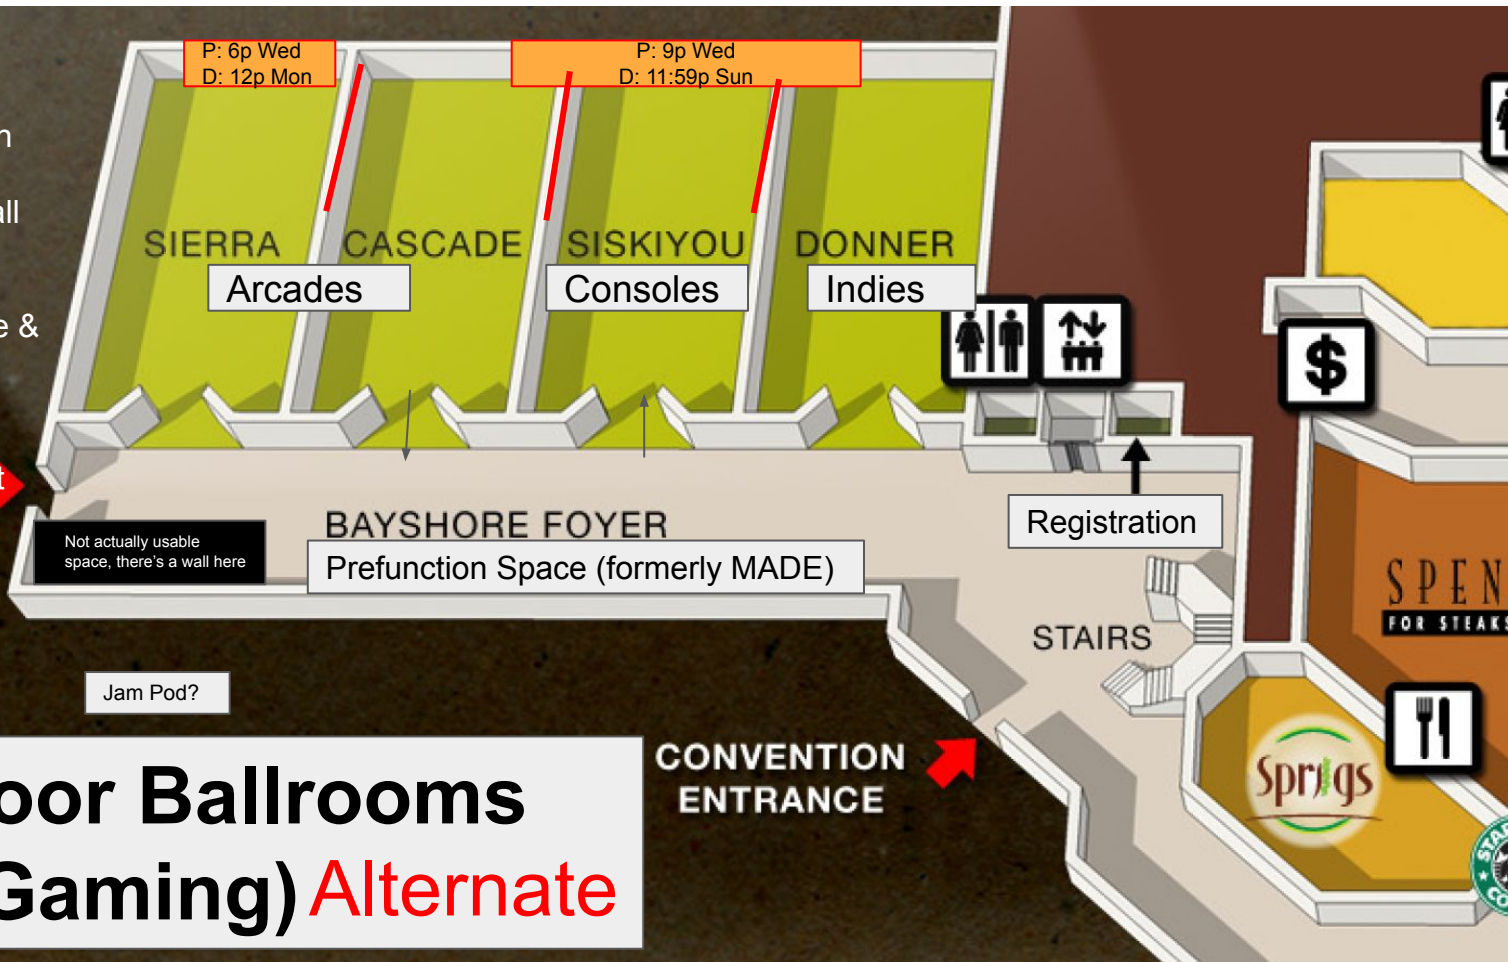


First Floor Ballrooms (Gaming) **Alternate**

CONVENTION
ENTRANCE

Red line
= pipe &
drape

P: 6a Thurs
D: 11:59p Sun

S

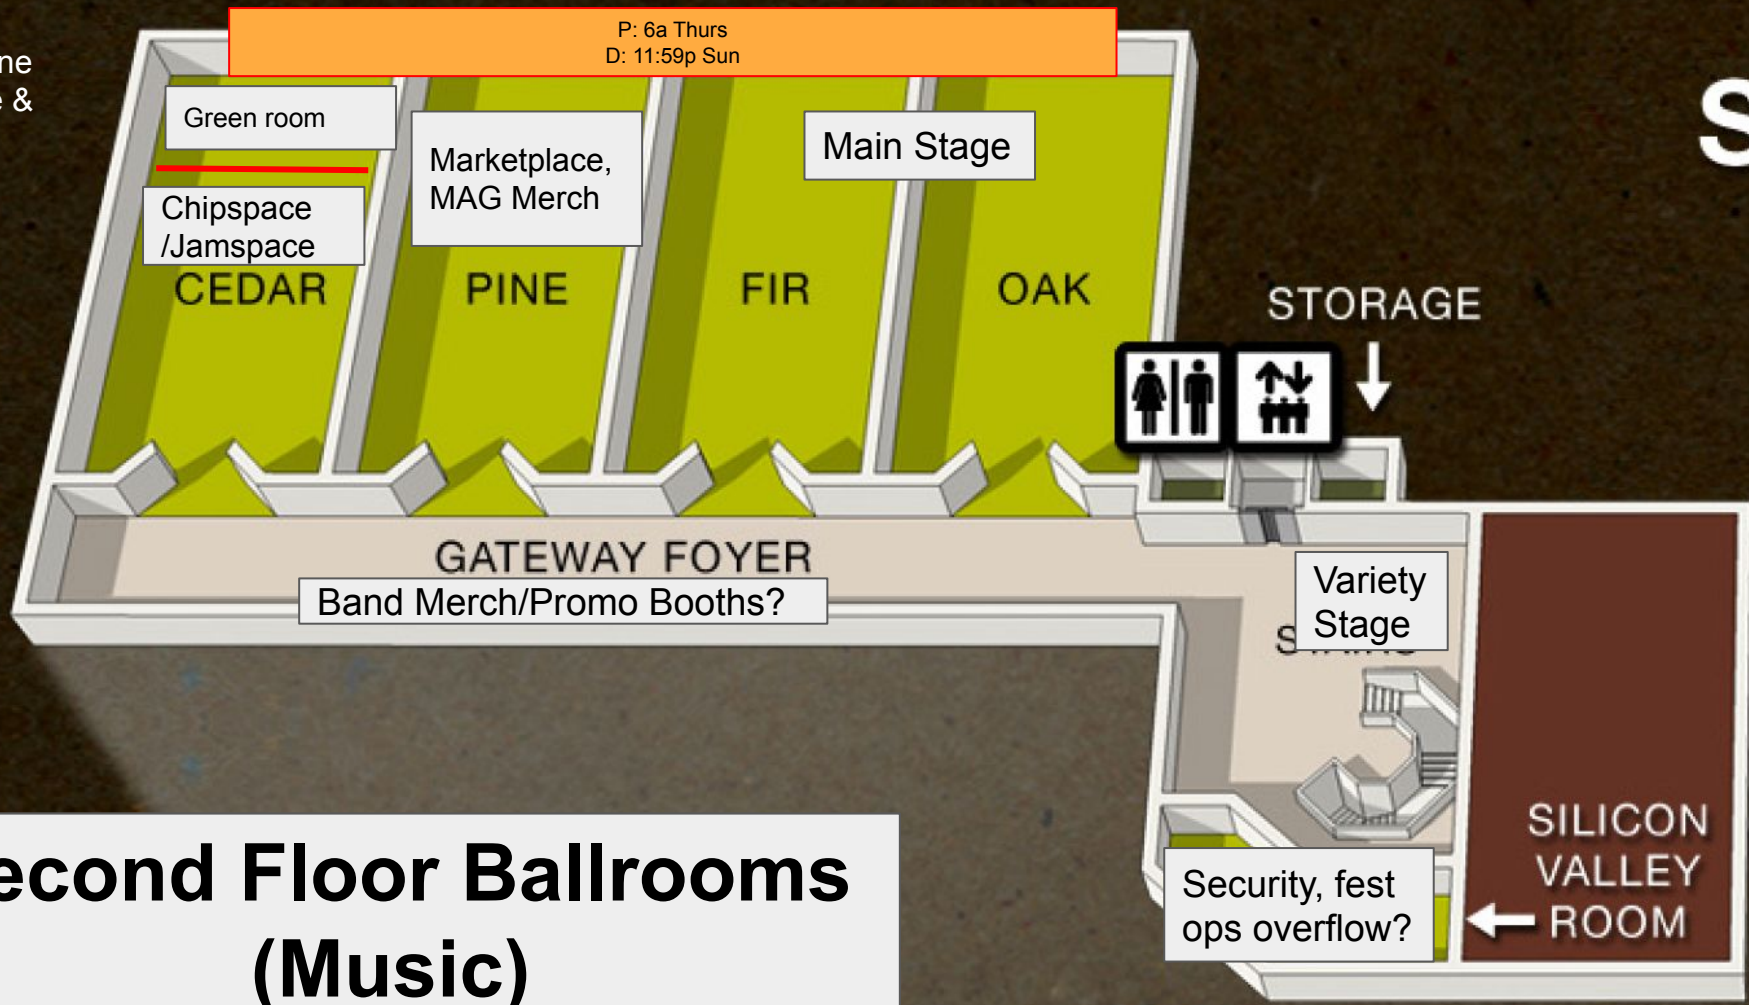

Second Floor Ballrooms (Music)

SECOND FLOOR

OPS Rooms (across from hotel rooms)



If LAN only uses 1 room, we can potentially expand Panels 2 and kick MAGES on the back hall. (see next slide)

Red line = hard walls (i.e., we can't just make these one big room)

White line = airwall option

P: 6a Thurs
D: 12a Mon




POOLSIDE FOYER

EXECUTIVE

Jam Pod?

SALES & CATERING

First Floor Panels, MAGES & ???

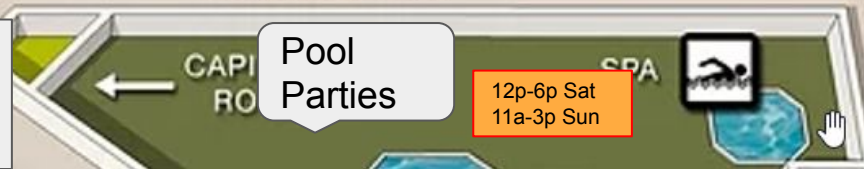

SECOND FLOOR


OPS Rooms (across from hotel rooms)




Red line = hard walls (i.e., we can't just make these one big room)

White line = airwall option

P: 6a Thurs
D: 12a Mon

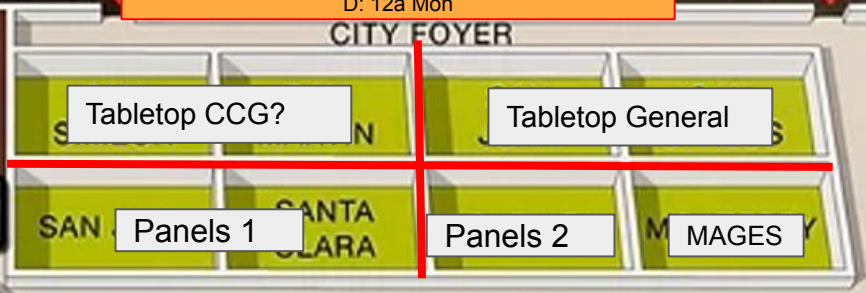

First Floor Alternate Panels, MAGES & ???

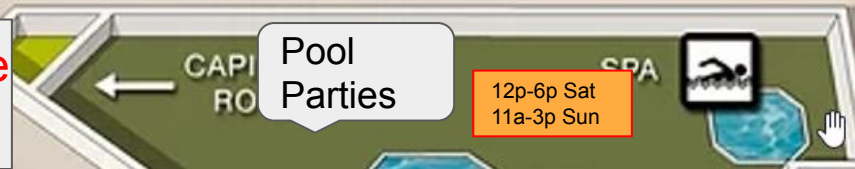

SECOND FLOOR

OPS Rooms (across from hotel rooms)



If LAN only uses 1 room, we can potentially expand Panels 2 and kick MAGES on the back hall. (see previous slide)

Red line = hard walls (i.e., we can't just make these one big room)

White line = airwall option

P: 6a Thurs
D: 12a Mon

CITY FOYER



GUEST ROOM ELEVATORS

EXECUTIVE

Jam Pod?

First Floor Alternate Panels, MAGES & ???

Pool Parties

12p-6p Sat
11a-3p Sun

SALES & CATERING

Virtual Tour (Google Maps) of the venue: [Here](#)